
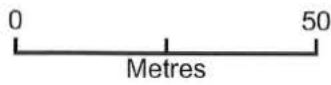
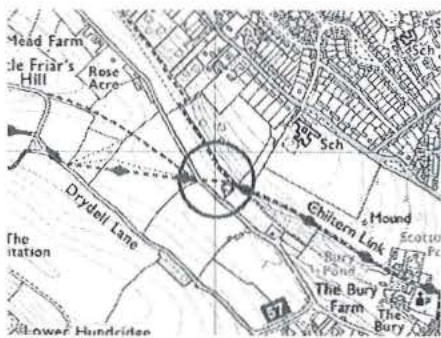


# Proposed Right of Way shown in Red Pednor, Chesham

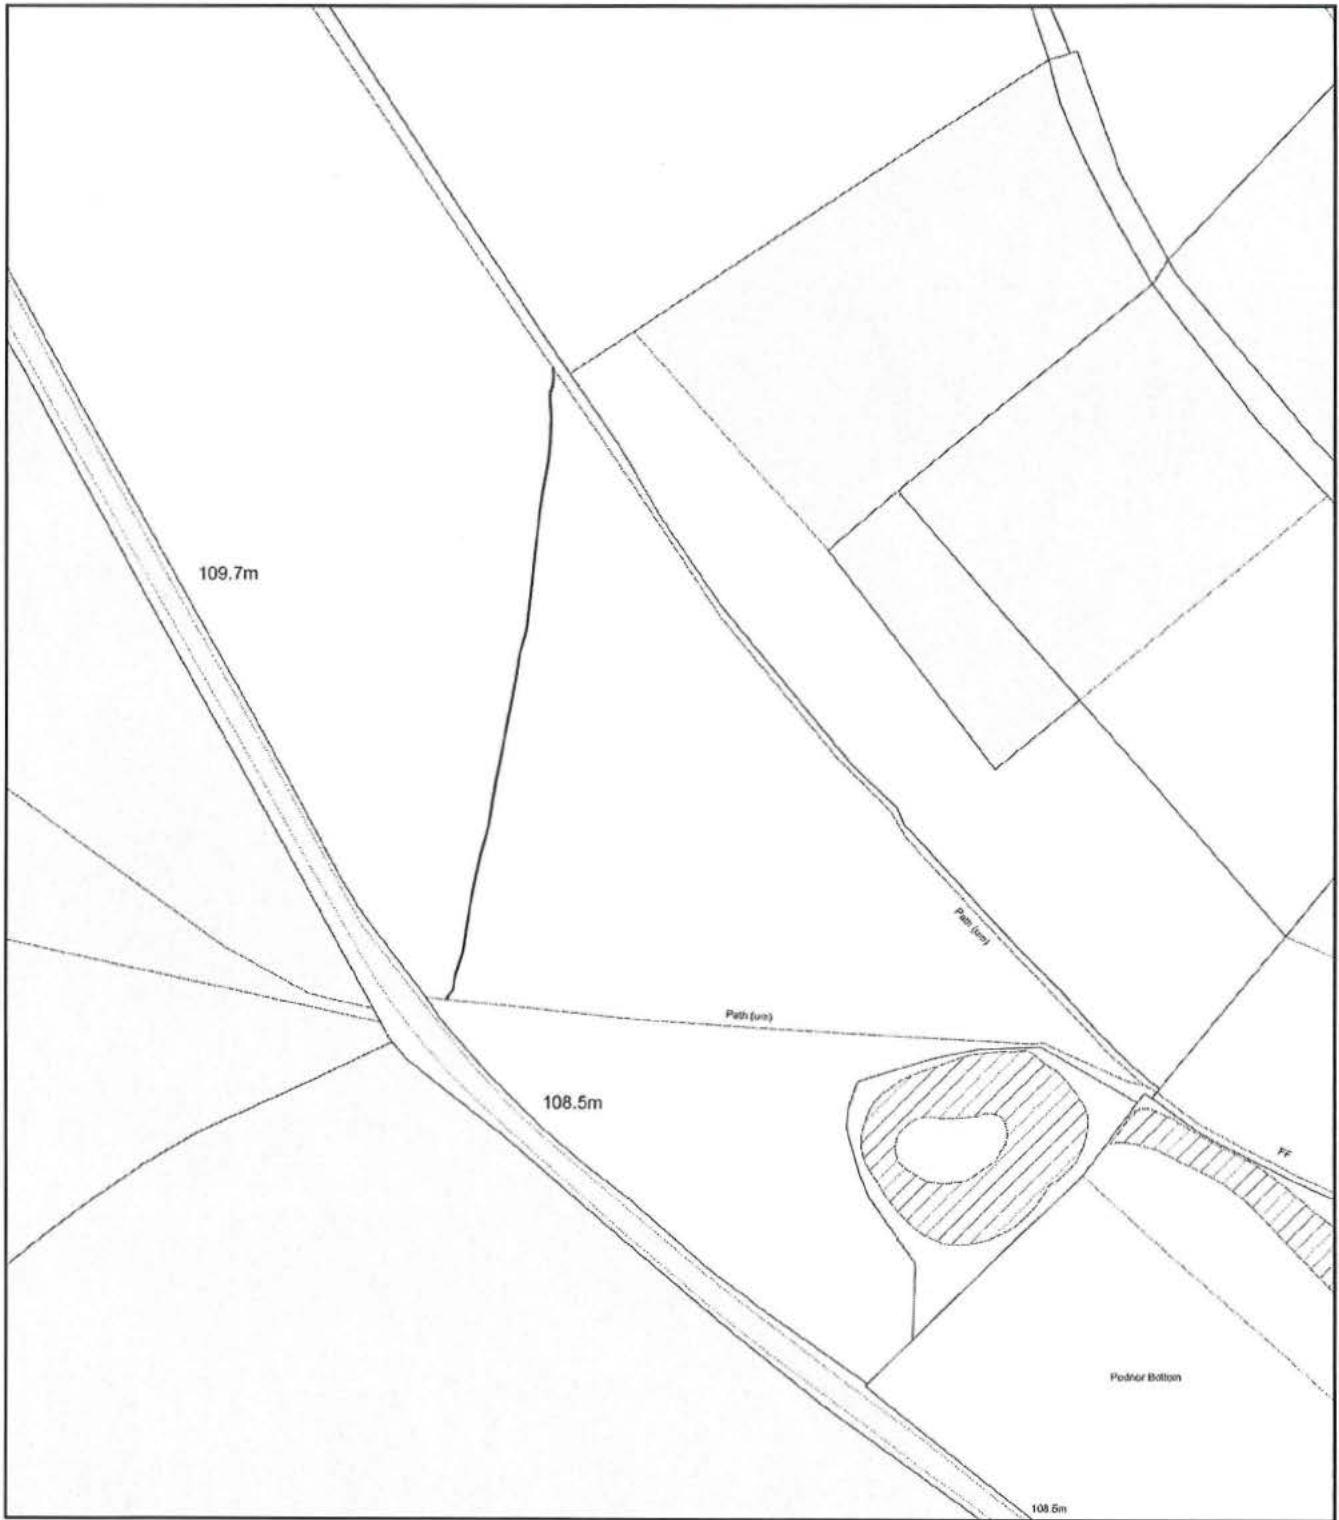

Date Produced: 07 May 2021  
Plan Reference Number: TQRQM21127200106038  
Scale: 1:1250 @ A4

**Add your initials and date below**  
[Redacted] 11-6-21